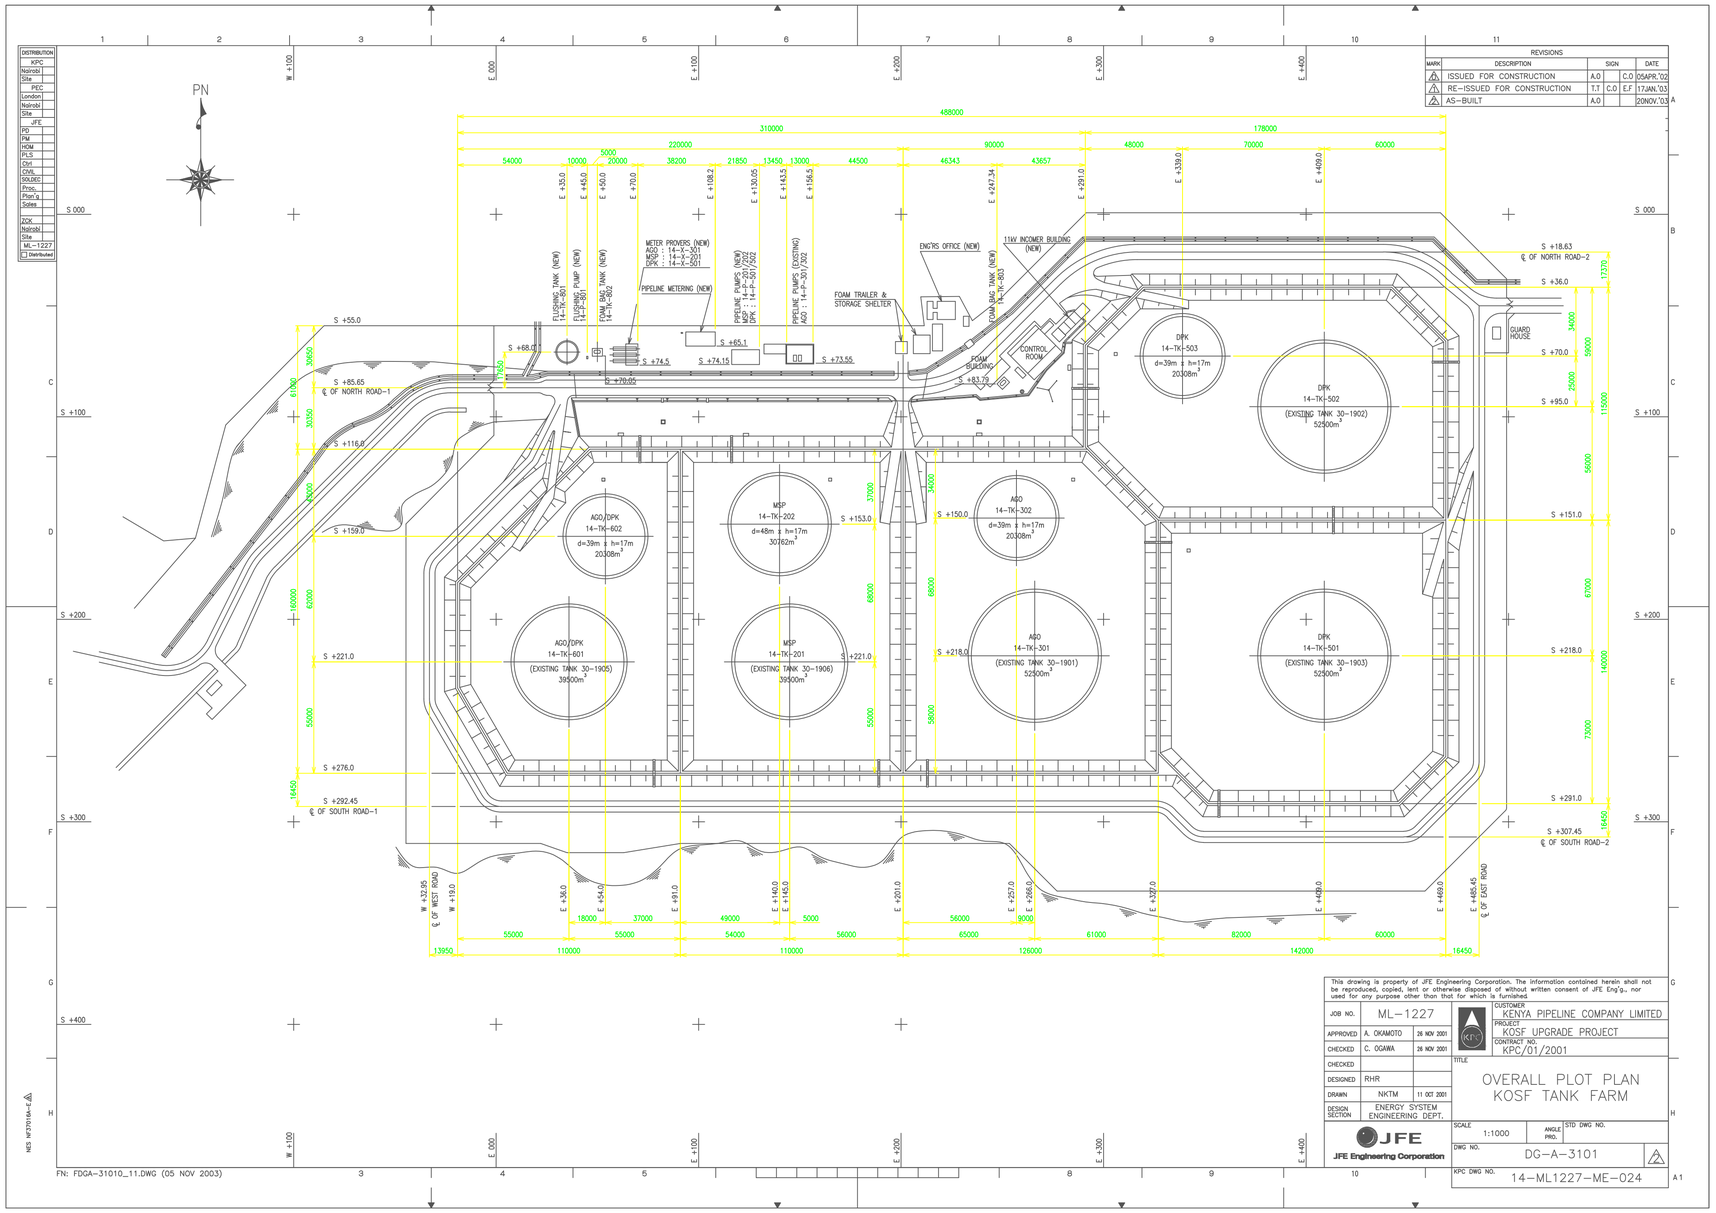

REVISIONS				
MARK	DESCRIPTION	SIGN		DATE
3	ISSUED FOR CONSTRUCTION	A.0	C.0	05APR.'02
2	RE-ISSUED FOR CONSTRUCTION	T.T	C.0	E.F 17JAN.'03
1	AS-BUILT	A.0		20NOV.'03

DISTRIBUTION
KPC
Nairobi
Site
PEC
London
Nairobi
Site
JFE
PD
PM
HDM
PLS
Ctrl
CIVIL
SOLDEC
Proc.
Plan'g
Sales
ZCK
Nairobi
Site
ML-1227
Distributed

This drawing is property of JFE Engineering Corporation. The information contained herein shall not be reproduced, copied, lent or otherwise disposed of without written consent of JFE Eng'g., nor used for any purpose other than that for which is furnished.

JOB NO.	ML-1227	
APPROVED	A. OKAMOTO	26 NOV 2001
CHECKED	C. OGAWA	26 NOV 2001
CHECKED		
DESIGNED	RHR	
DRAWN	NKTM	11 OCT 2001
DESIGN SECTION	ENERGY SYSTEM ENGINEERING DEPT.	

JFE
JFE Engineering Corporation

CUSTOMER: KENYA PIPELINE COMPANY LIMITED
PROJECT: KOSF UPGRADE PROJECT
CONTRACT NO.: KPC/01/2001

TITLE: OVERALL PLOT PLAN KOSF TANK FARM

SCALE: 1:1000 | ANGLE PRO. | STD DWG NO.
DWG NO.: DG-A-3101 (2)
KPC DWG NO.: 14-ML1227-ME-024

FN: FDGA-31010_11.DWG (05 NOV 2003)